

BC LAND SURVEYOR'S TOPOGRAPHIC SURVEY

ON STRATA LOT 15, D.L. 7924, STRATA PLAN BCS161, Gp.1, N.W.D.
1554 Tynebridge Lane, Whistler, B.C.




The intended plot size is 280mm in width by 432mm in height (B Size) when plotted at a scale of 1:150.
All distances are horizontal ground-level distances in metres and decimals thereof, unless otherwise noted.



LEGEND

- TOP ROCK STACK WALL
- TOE ROCK STACK WALL


SPOT ELEVATION

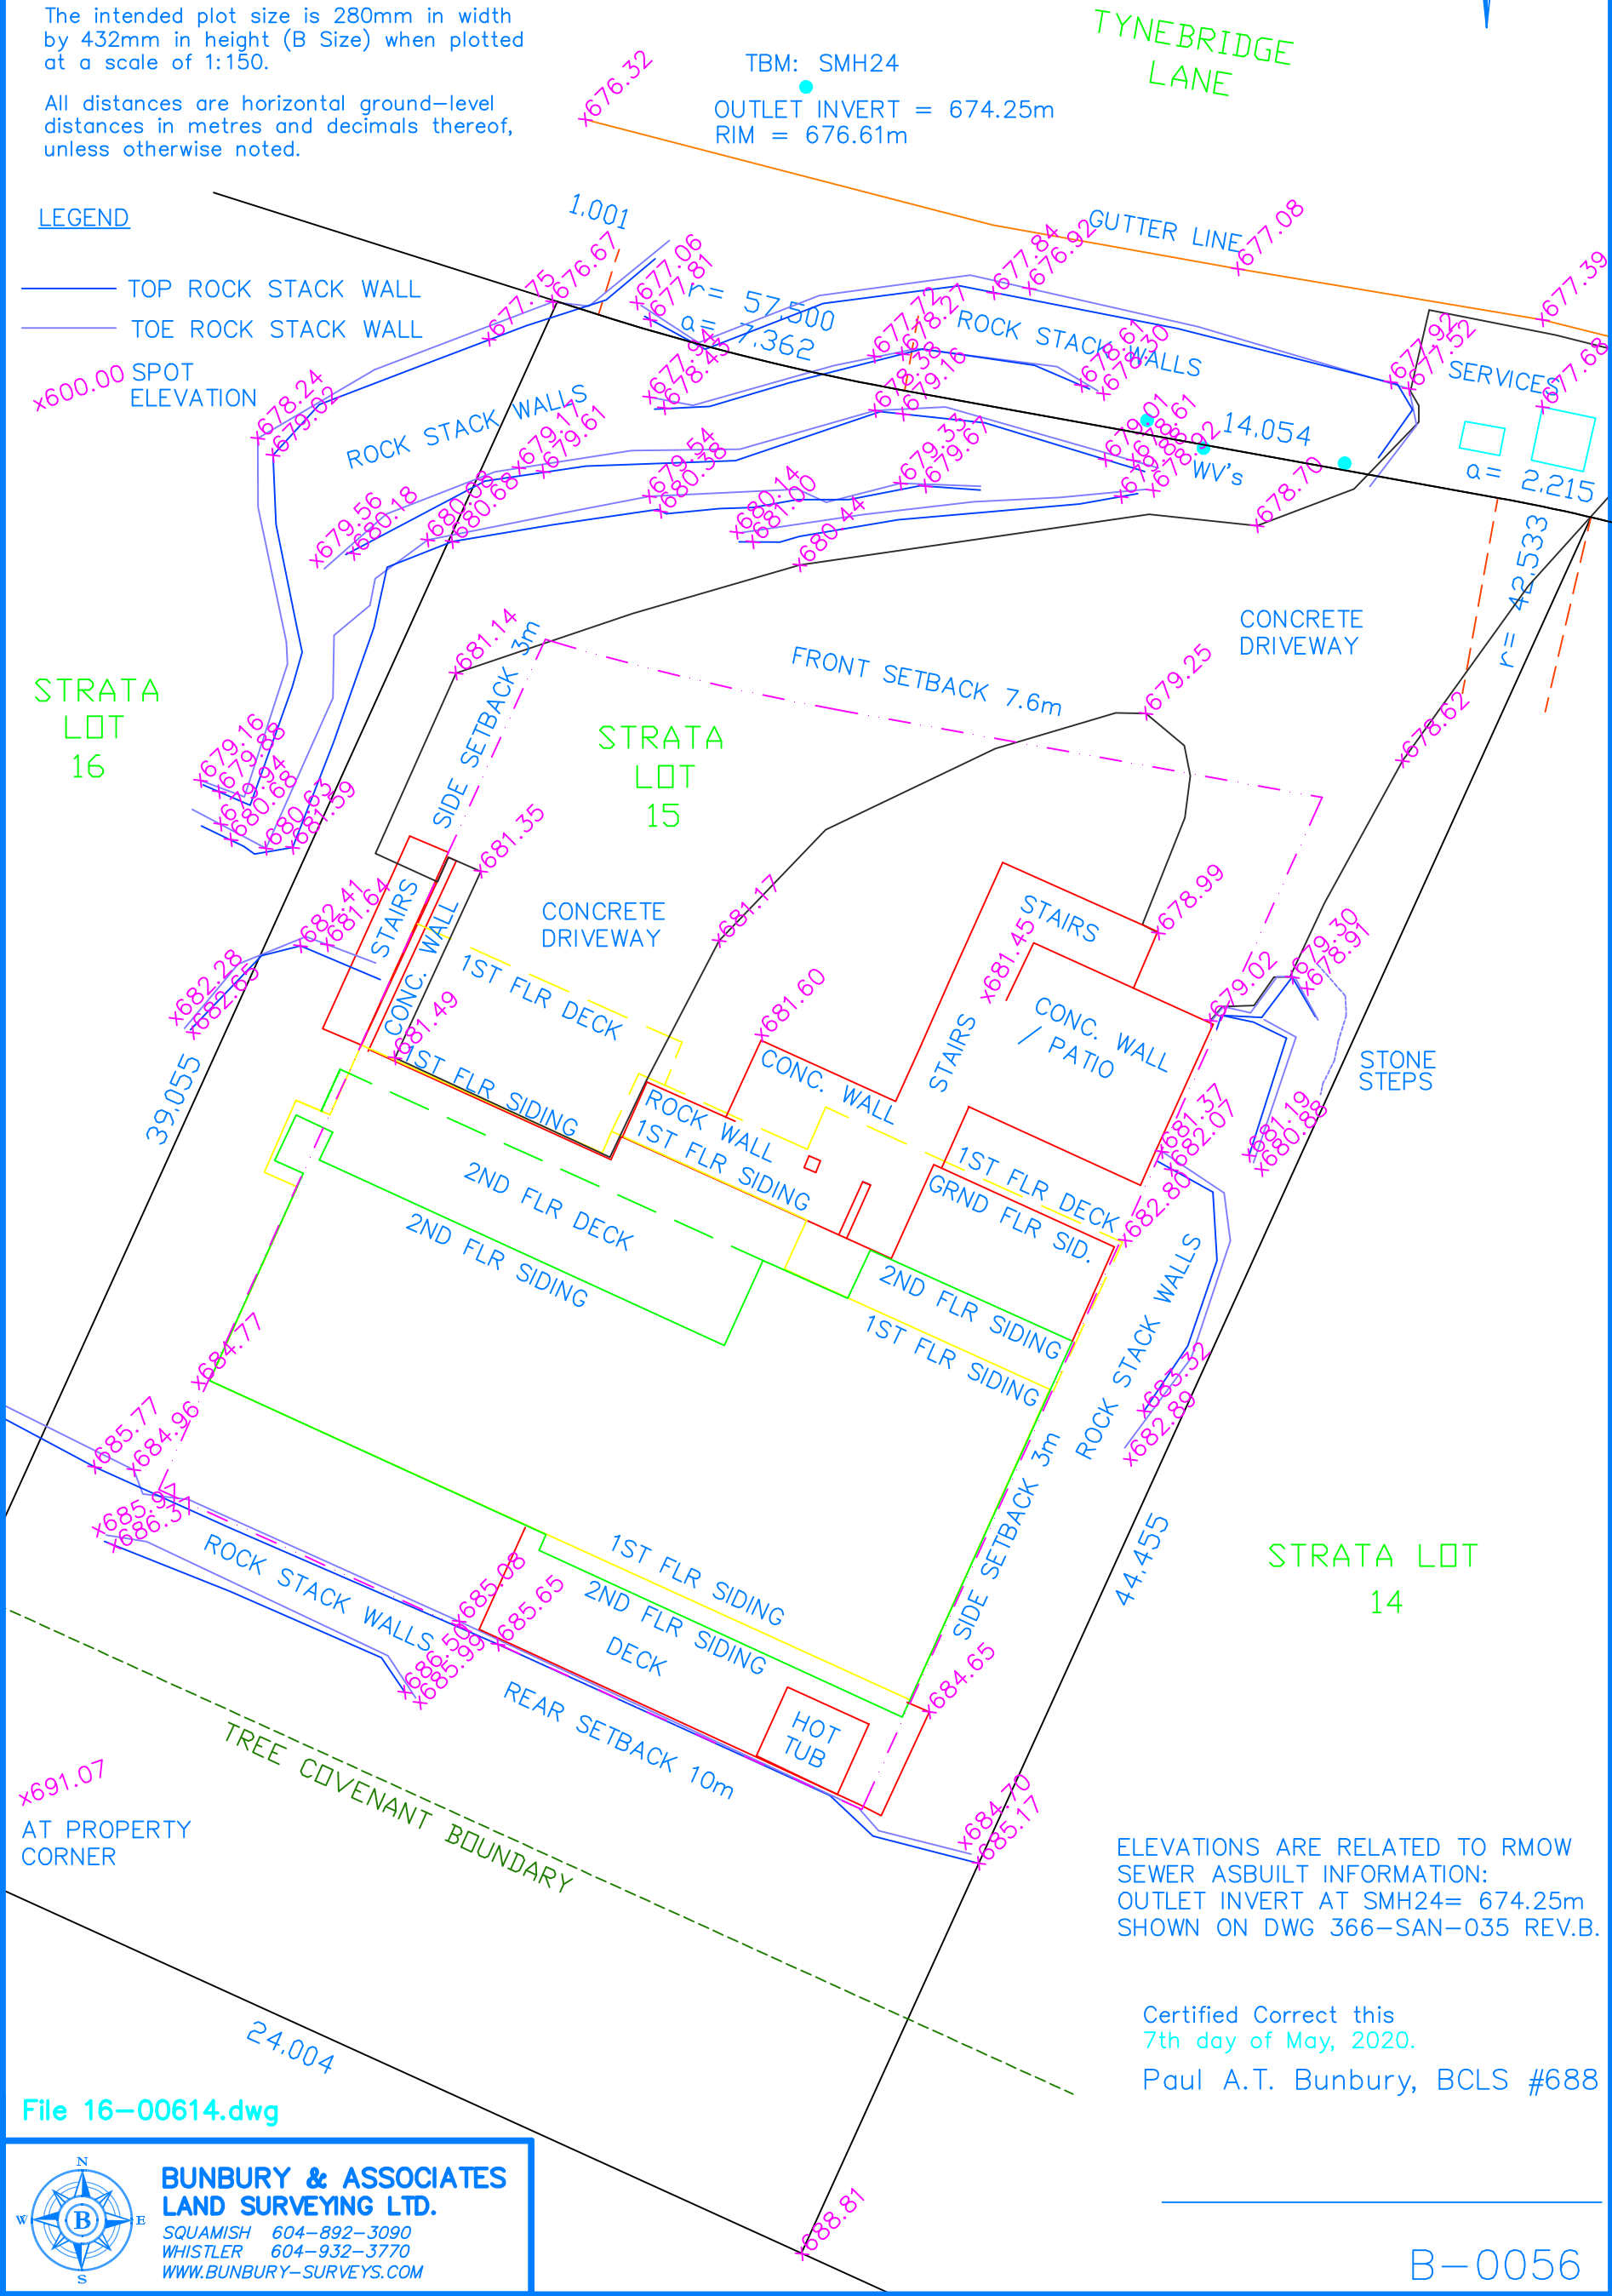

ELEVATIONS ARE RELATED TO RMOW
SEWER ASBUILT INFORMATION:
OUTLET INVERT AT SMH24= 674.25m
SHOWN ON DWG 366-SAN-035 REV.B.

Certified Correct this
7th day of May, 2020.
Paul A.T. Bunbury, BCLS #688

File 16-00614.dwg

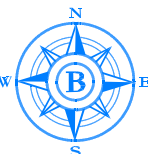

**BUNBURY & ASSOCIATES
LAND SURVEYING LTD.**
SQUAMISH 604-892-3090
WHISTLER 604-932-3770
WWW.BUNBURY-SURVEYS.COM