

BC LAND SURVEYOR'S TOPOGRAPHIC SURVEY PLAN

ON STRATA LOT 41, D.L. 7135, PLAN VR2639, NWD.
2461 Snow Valley Place, Whistler, BC




The intended plot size is 432mm in width by 280mm in height (B Size) when plotted at a scale of 1:300.

All distances are horizontal ground-level distances in metres and decimals thereof, unless otherwise noted.


SITE BENCHMARK:
TAG #429
Elev= 704.65m

Elev. derived from San. Manhole S-25
Invert Elev.= 701.75m as shown
on Kerr Wood Leidal Ass. Ltd
As-built drawing No. 235.88.6

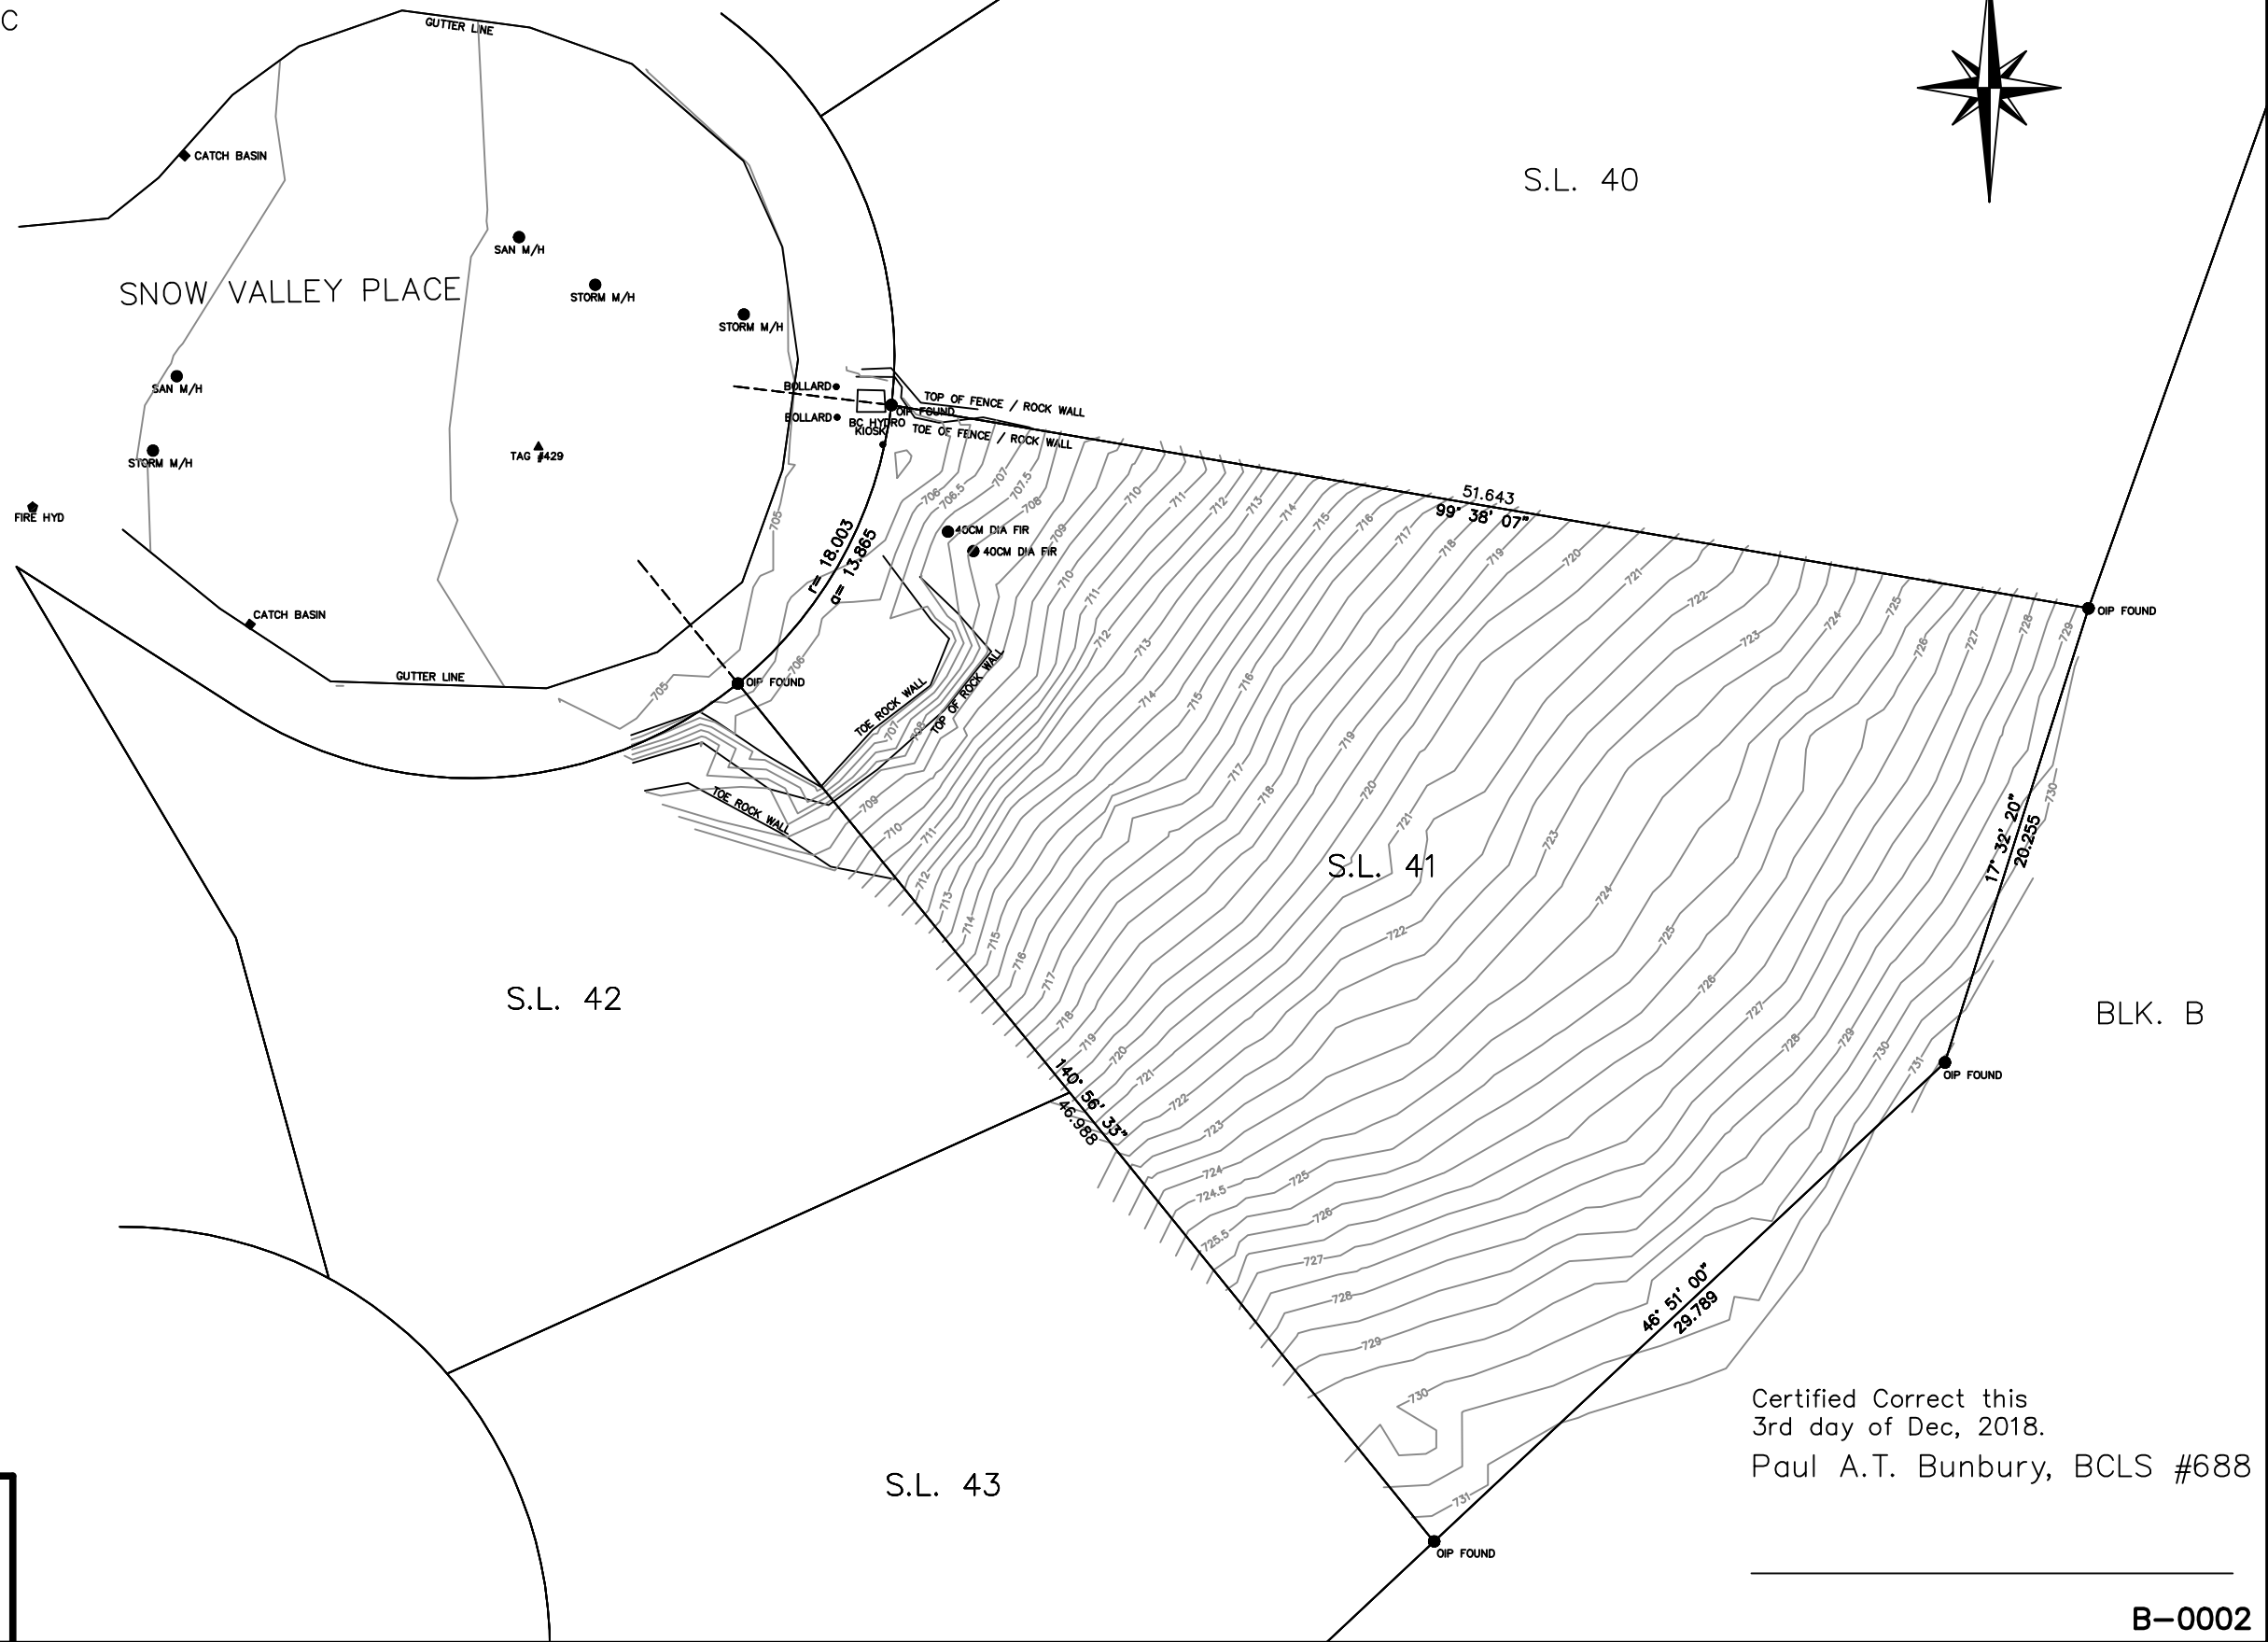

x 298.8 Denotes Existing
Ground Elevation

FB 2153 Pg 25-28
File 18-05201.dwg

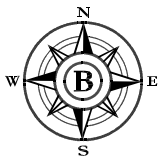

**BUNBURY & ASSOCIATES
LAND SURVEYING LTD.**
SQUAMISH 604-892-3090
WHISTLER 604-932-3770
WWW.BUNBURY-SURVEYS.COM

Certified Correct this
3rd day of Dec, 2018.
Paul A.T. Bunbury, BCLS #688