


YARD LANDSCAPE UPGRADE
PROPOSED BRIEF WORK

Maintain existing roof structure presently encroaching
down into covenant rear yard.

Move living room window to rear wall and replace with
one large paper face concrete planter to create more
organized frame for rear patio.

Move hot tub to south side of yard maintaining a distance
of 5.5m from property line and construct light weight
canopy for weather protection.

Create planting zones to neighbouring properties for
in effective privacy screen.

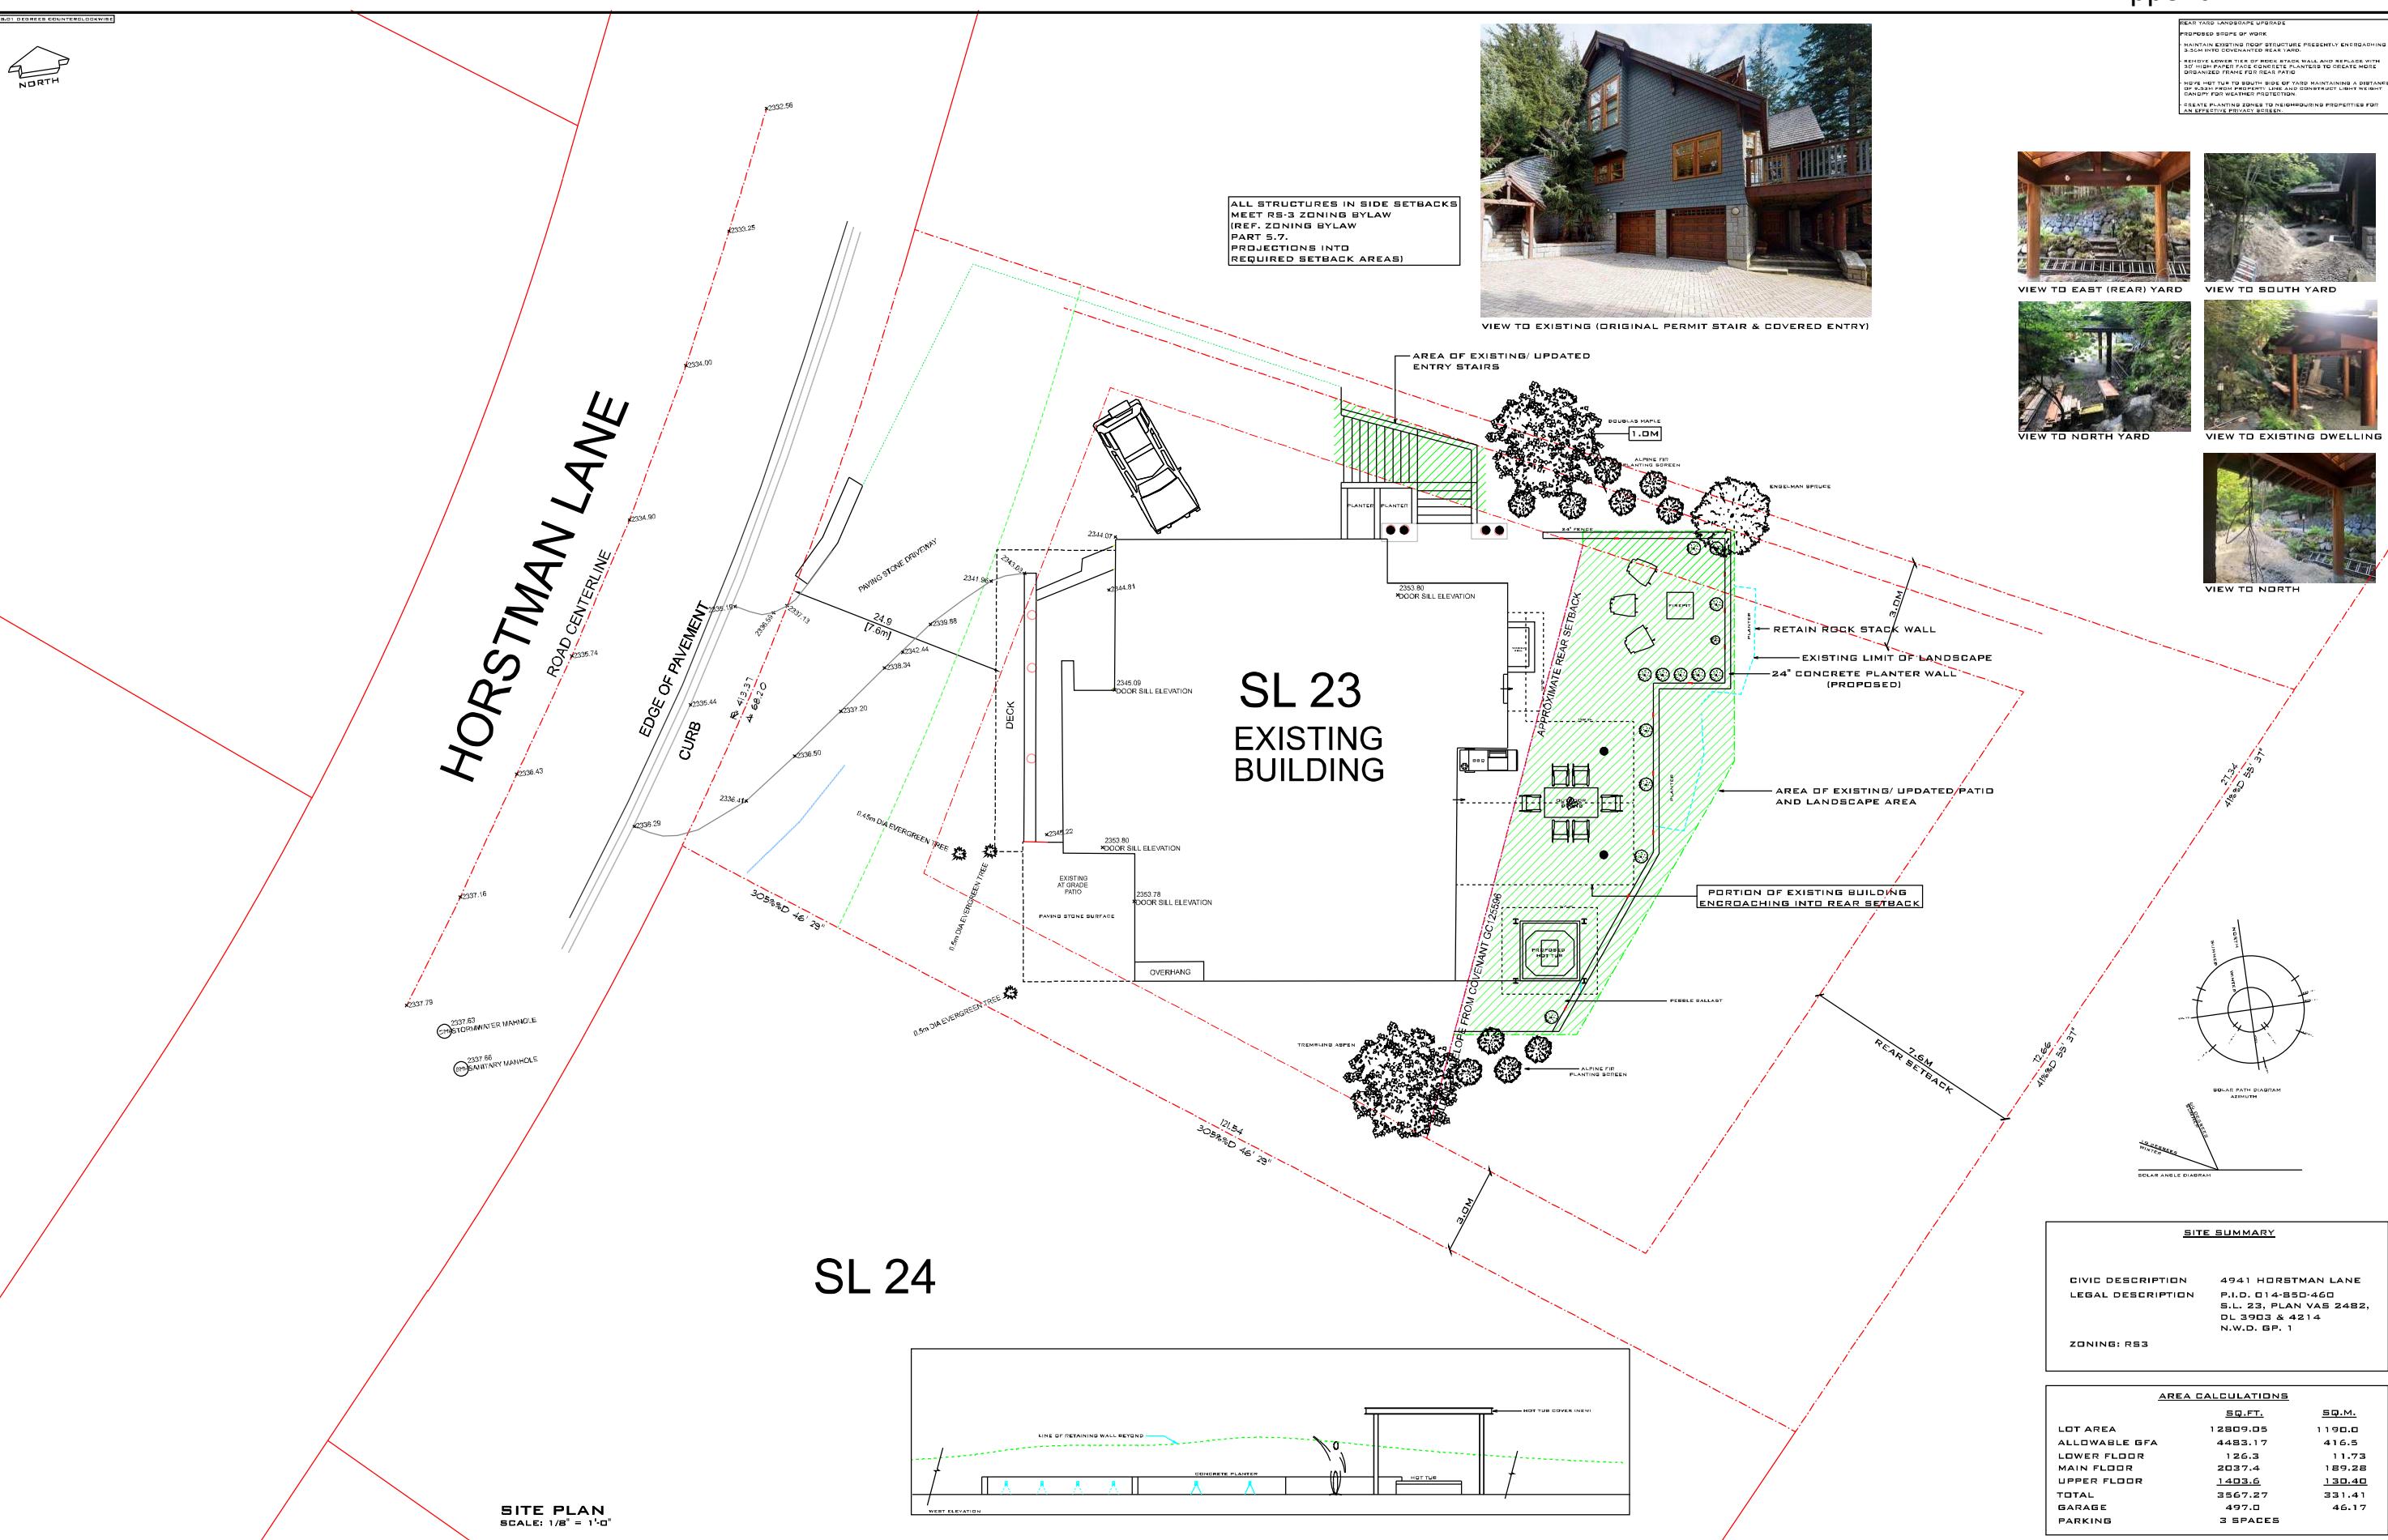

NOTE: ALL ASPECTS OF CONSTRUCTION SHALL CONFORM TO THE BCSC 2018 - PART 9 U.N.O.

SITE PL.
SCALE: 1/8" =

**SENFT
4941 HORSTMAN LANE
SITE PLAN**

SEAN ANDERSON

DATE:	TUESDAY, DECEMBER 22, 2020		
DRAWN BY:	S.A.		
SCALE:	1"	2"	3"


100


30.03.26 ISSUE FOR REVIEW	
30.03.29 GENERAL COORDINATION	20.11.11 GENERAL REVISIONS
30.03.12 ISSUE FOR R.F.P.	20.10.21 GENERAL REVISIONS
19.12.11 ISSUE FOR REVIEW V02	20.10.14 GENERAL REVISIONS
20.03.01 ISSUE FOR REVIEW V03	20.03.01 GENERAL REVISIONS


COPYRIGHT RESERVED!
THIS PRINT DOCUMENT IS THE EXCLUSIVE
PROPERTY OF
PROGRESSIVE CONCEPT DESIGN LTD.
AND MAY NOT BE USED OR REPRODUCED
WITHOUT EXPRESS WRITTEN CONSENT
OF THE DESIGNER.

A-0 1

DRAWING NUMBER

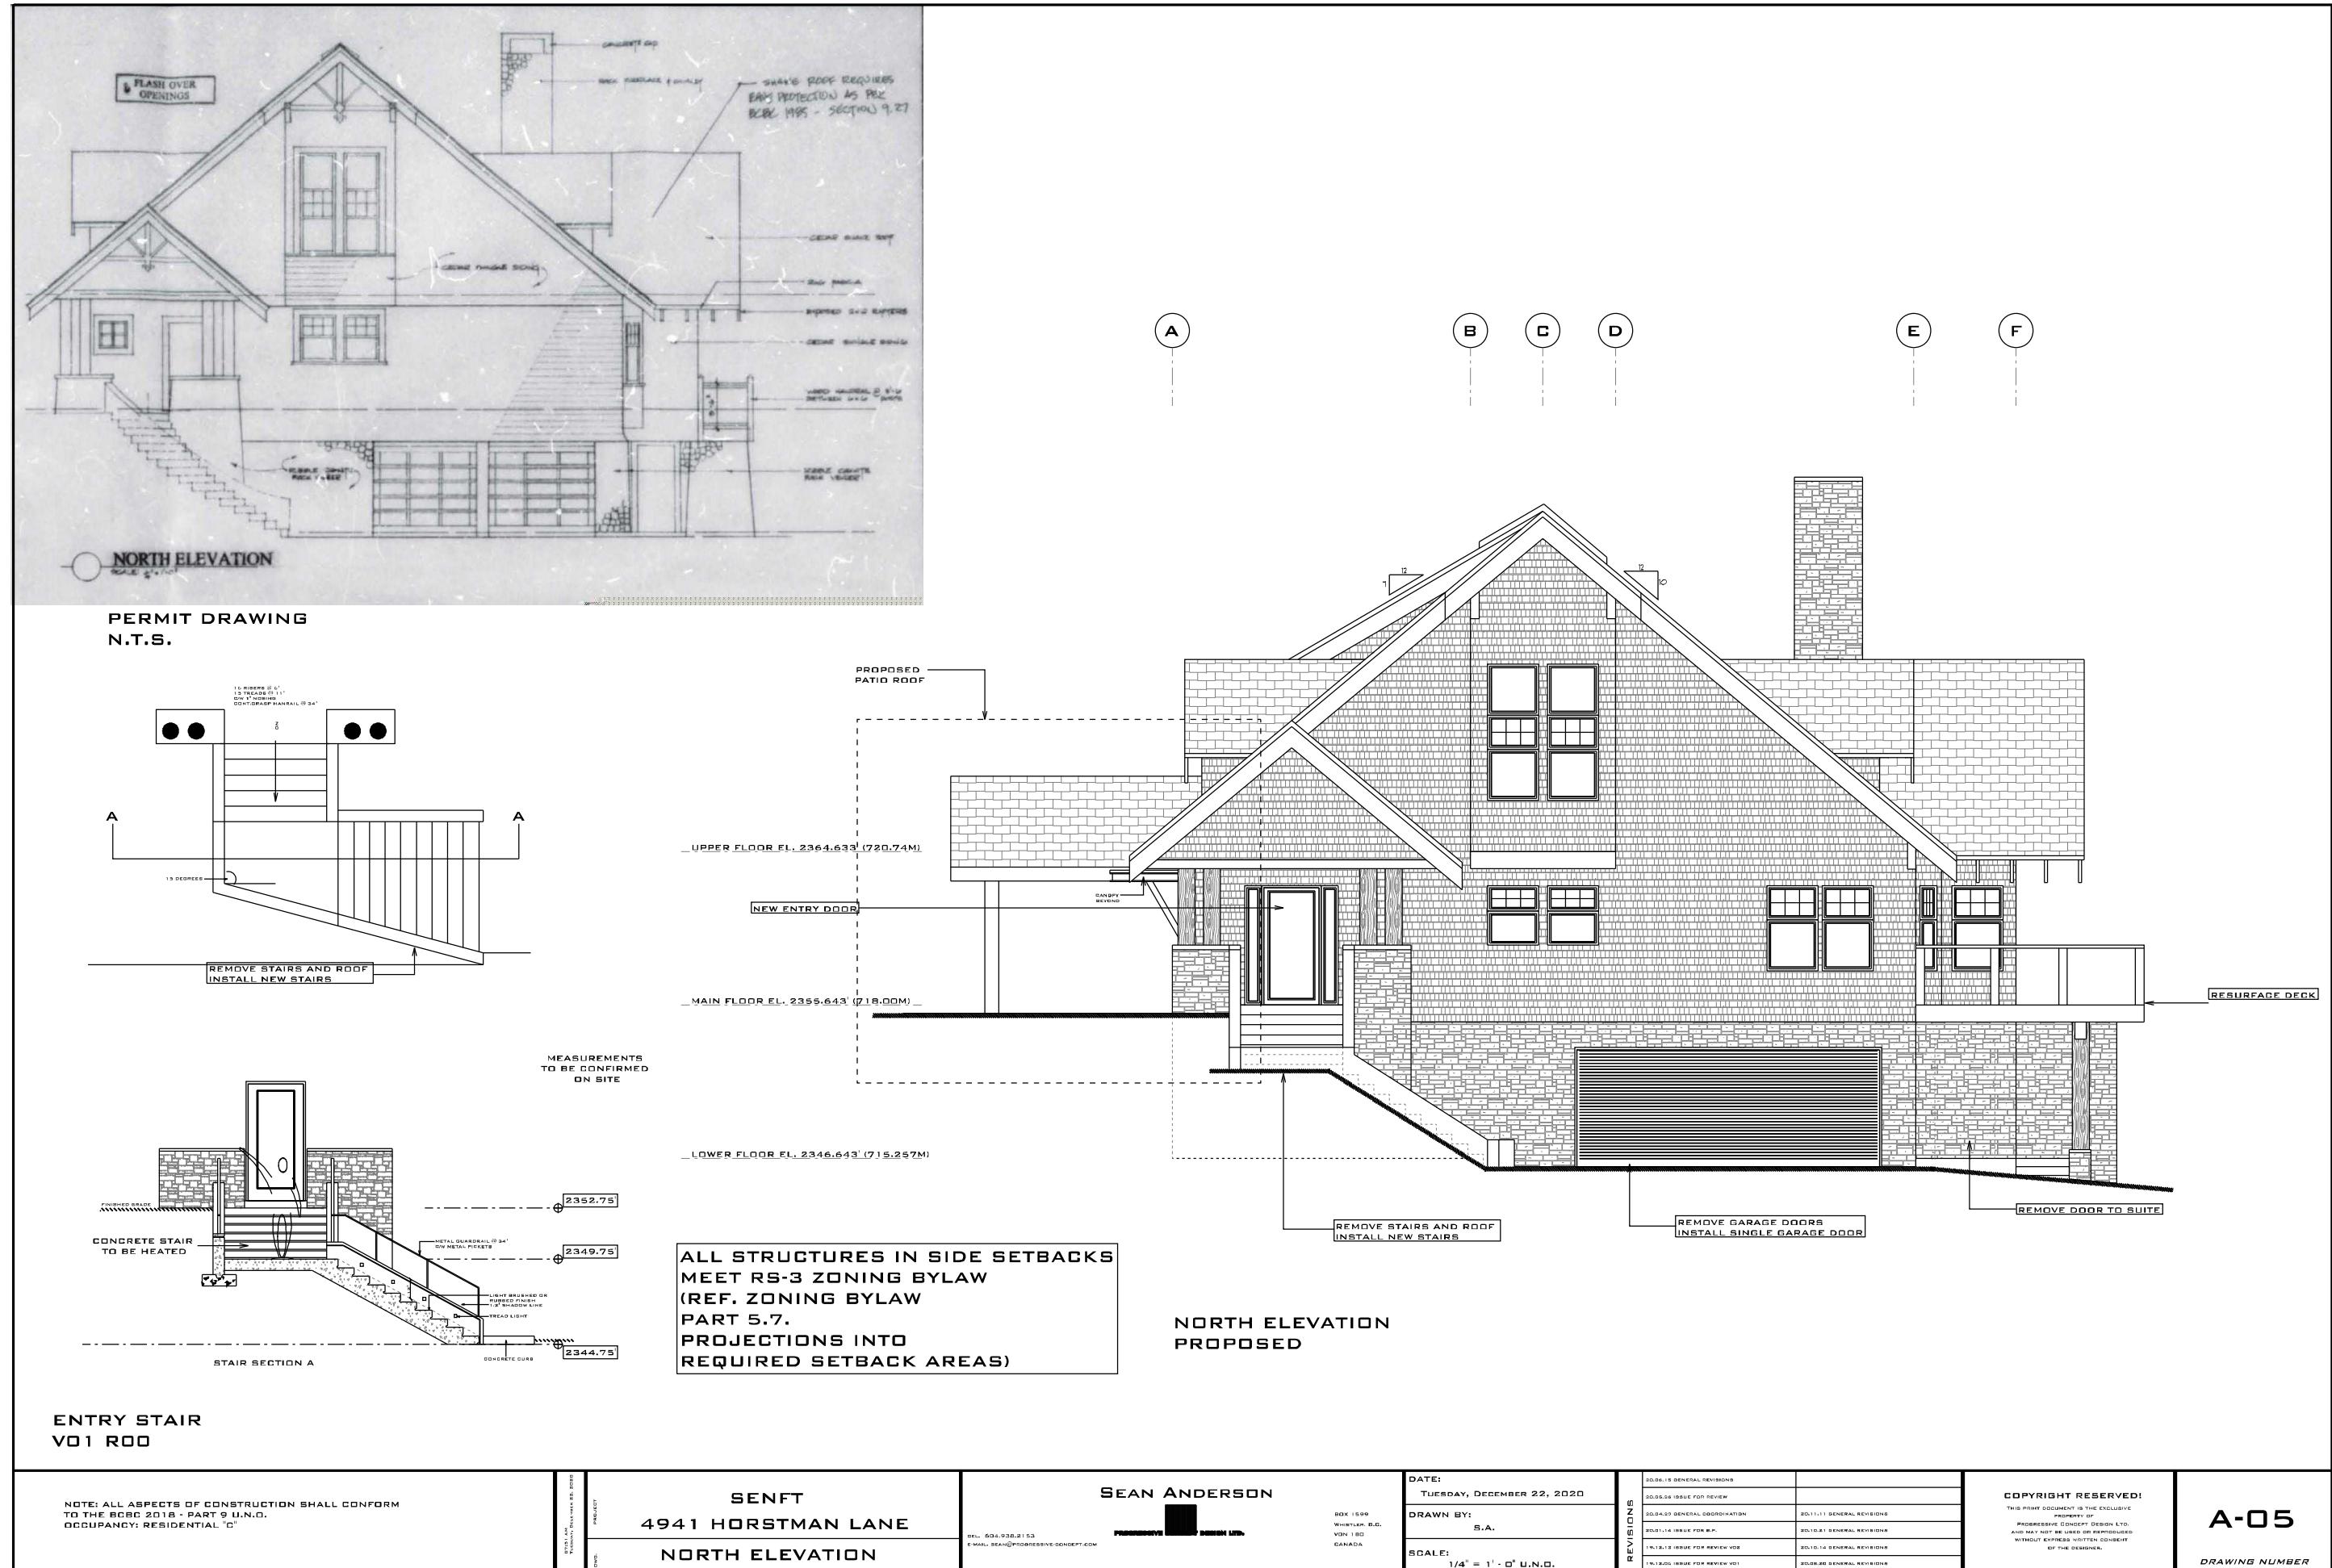

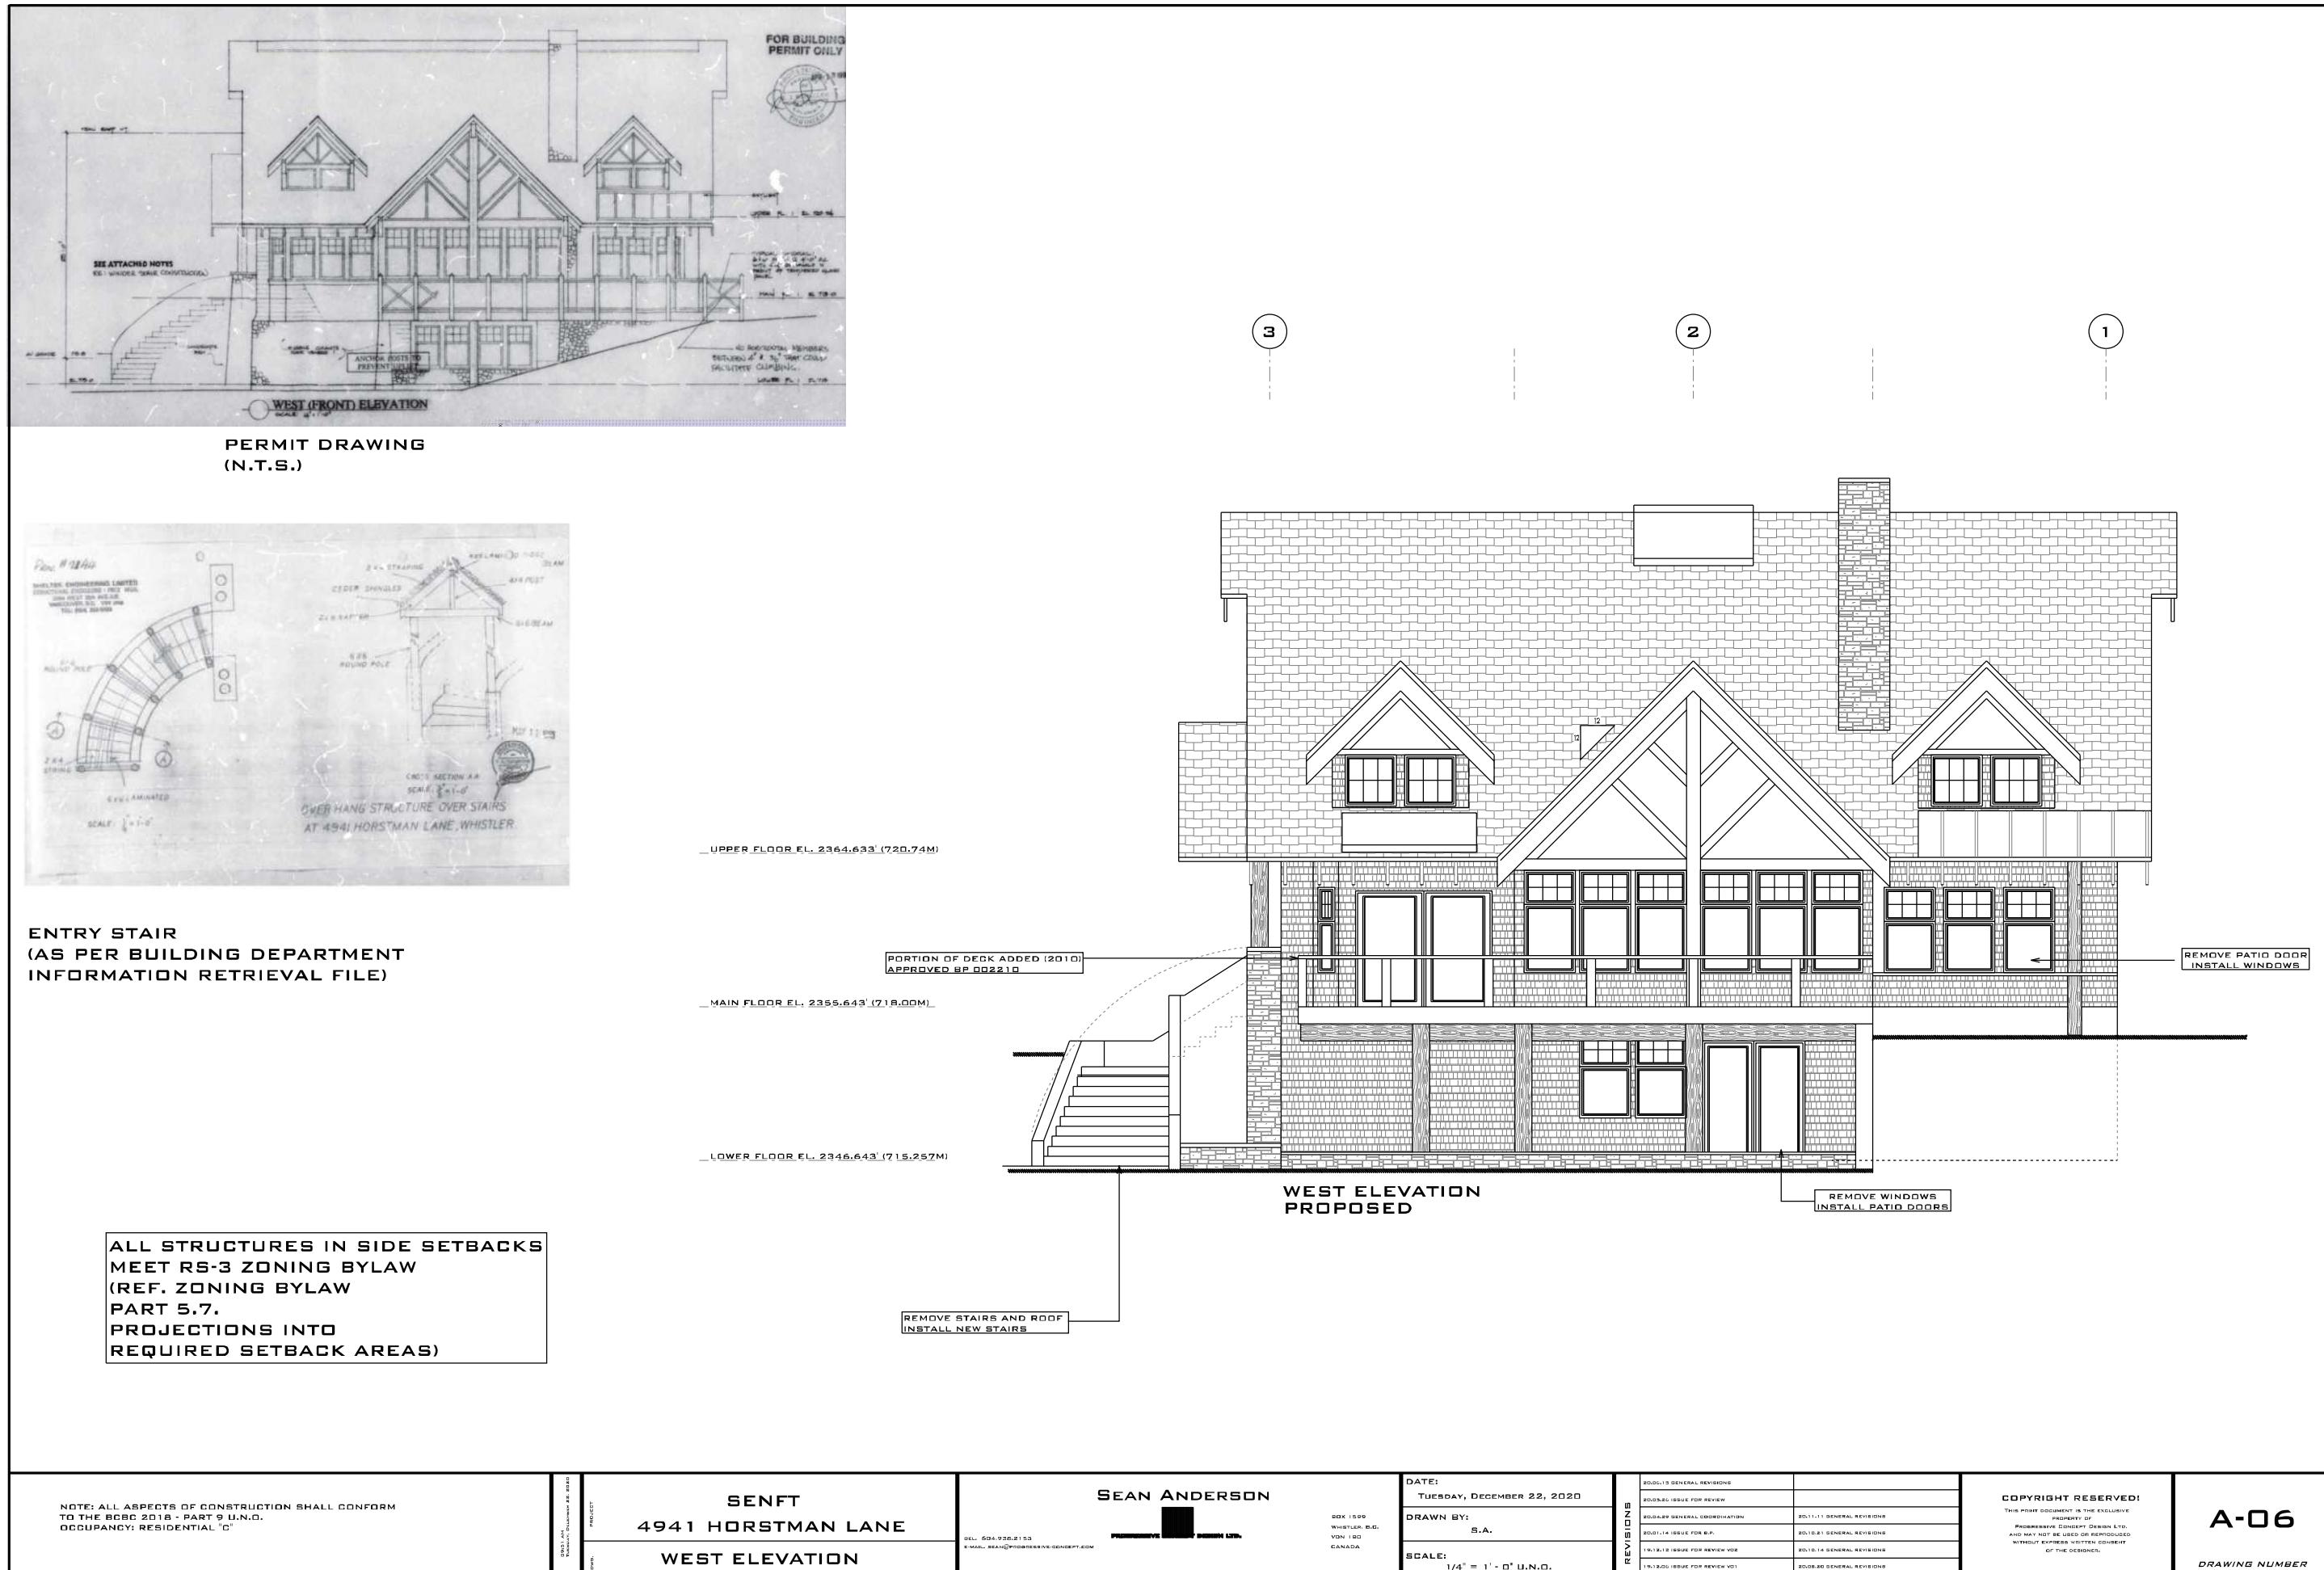

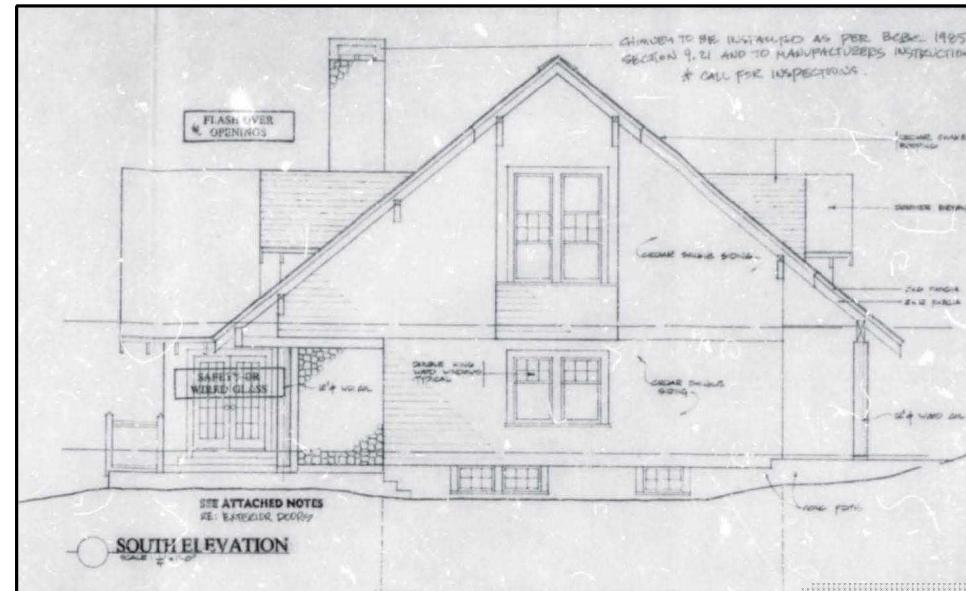

**PERMIT DRAWING
(N.T.S.)**



**SOUTH ELEVATION
AS BUILT
SCALE: 1/8" = 1'-0"**



**SOUTH ELEVATION
PROPOSED**

**NOTE: ALL ASPECTS OF CONSTRUCTION SHALL CONFORM
TO THE BCBC 2018 - PART 9 U.N.O.
OCCUPANCY: RESIDENTIAL "C"**

**SENFT
4941 HORSTMANN LANE
SOUTH ELEVATION**

SEAN ANDERSON

BOX 1
WHEAT
VON I
CANADA

DATE:
TUESDAY, DECEMBER 22, 2020

DRAWN BY:
S.A.

SCALE: 1/4" = 1'-0" H.H.C.


REVISIONS	SOL02-15 GENERAL REVISIONS	
	SOL02-26 ISSUE FOR REVIEW	
	SOL04-04 GENERAL COORDINATION	SOL11-11 GENERAL REVISIONS
	SOL10-14 ISSUE FOR R.P.	SOL10-21 GENERAL REVISIONS
	SOL11-01 ISSUE FOR REVIEW VDR	SOL10-14 GENERAL REVISIONS

COPYRIGHT RESERVED!
THIS PRINT DOCUMENT IS THE EXCLUSIVE
PROPERTY OF
PROGRESSIVE CONCERT DESIGN LTD.
AND MAY NOT BE USED OR REPRODUCED
WITHOUT EXPRESS WRITTEN CONSENT
OF THE DESIGNER.

A-07



**PERMIT DRAWING
(N.T.S.)**

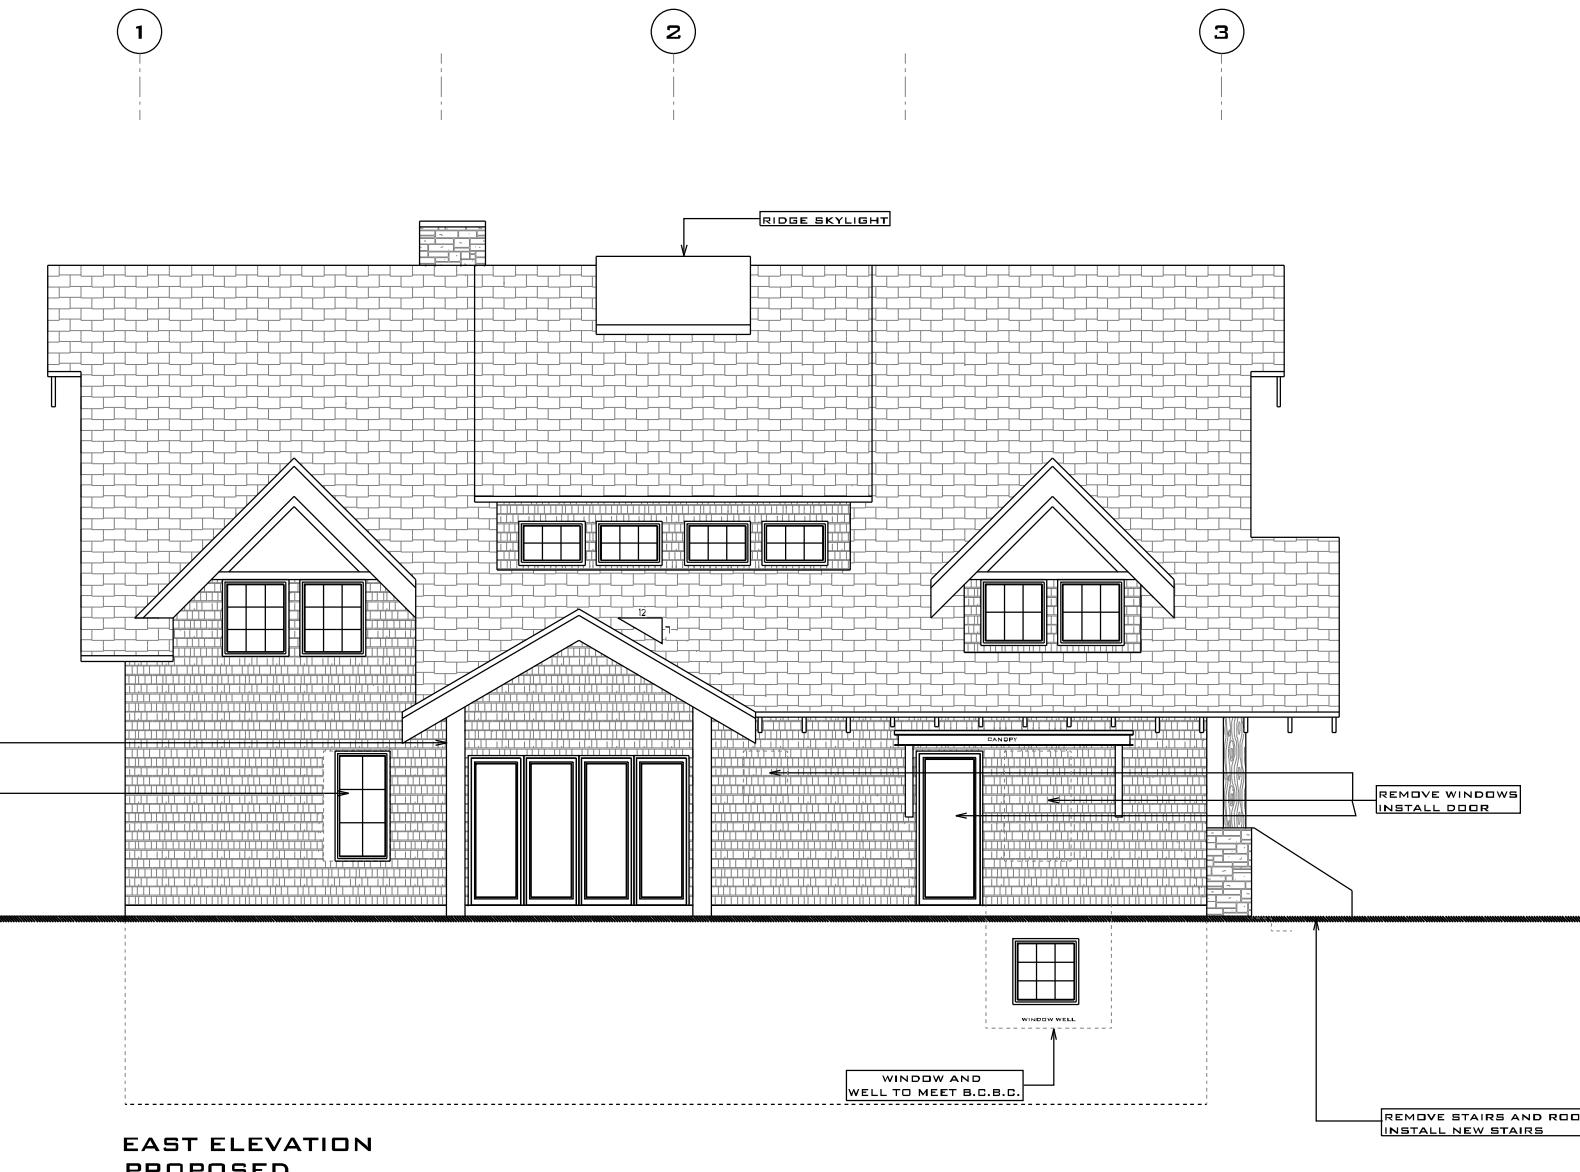

**EAST ELEVATION
PROPOSED**

NOTE: ALL ASPECTS OF CONSTRUCTION SHALL CONFORM TO THE BCBC 2018 - PART 9 U.N.O. OCCUPANCY: RESIDENTIAL 'C'	PROJECT Dwg 1204 AM Prepared by: Sean Anderson Reviewed by: Sean Anderson Date: 17/12/2020	SENFT 4941 HORSTMAN LANE EAST ELEVATION	SEAN ANDERSON Progressive Concept Design Ltd.	DATE: THURSDAY, DECEMBER 17, 2020 DRAWN BY: S.A. SCALE: 1/4" = 1'- 0" U.N.O.	REVISIONS 20.03.2G ISSUE FOR REVIEW 20.04.2G GENERAL COORDINATION 20.04.14 ISSUE FOR B.P. 19.12.12 ISSUE FOR REVIEW V02 19.12.09 ISSUE FOR REVIEW V01 20.03.2G GENERAL COORDINATION 20.04.11 GENERAL REVISIONS 20.04.21 GENERAL REVISIONS 20.04.20 GENERAL REVISIONS 20.04.20 GENERAL REVISIONS	COPYRIGHT RESERVED: THIS PRINT DOCUMENT IS THE EXCLUSIVE PROPERTY OF PROGRESSIVE CONCEPT DESIGN LTD. AND MAY NOT BE USED OR REPRODUCED WITHOUT EXPRESS WRITTEN CONSENT OF THE DESIGNER.	A-08 DRAWING NUMBER
--	---	---	--	---	---	--	------------------------