


B.C. LAND SURVEYOR'S BUILDING LOCATION CERTIFICATE
 OF ROCK STACK RETAINING WALLS ON LOT 1, BLOCK D, DISTRICT LOT 3625,
 PLAN 12376, Gp. 1, NEW WESTMINSTER DISTRICT
 9206 Emerald Drive, Whistler, B.C..

Distances shown are in metres
 and are derived from Plan 12376

SCALE : 1 : 250

3 2 1 0 5 10 15

ELEVATIONS ARE IN METRES AND ARE REFERRED TO
 R.M.O.W. AS BUILT SEWER DRAWING No. 179.13.4
 MANHOLE No. EE3.2 INVERT 646.900

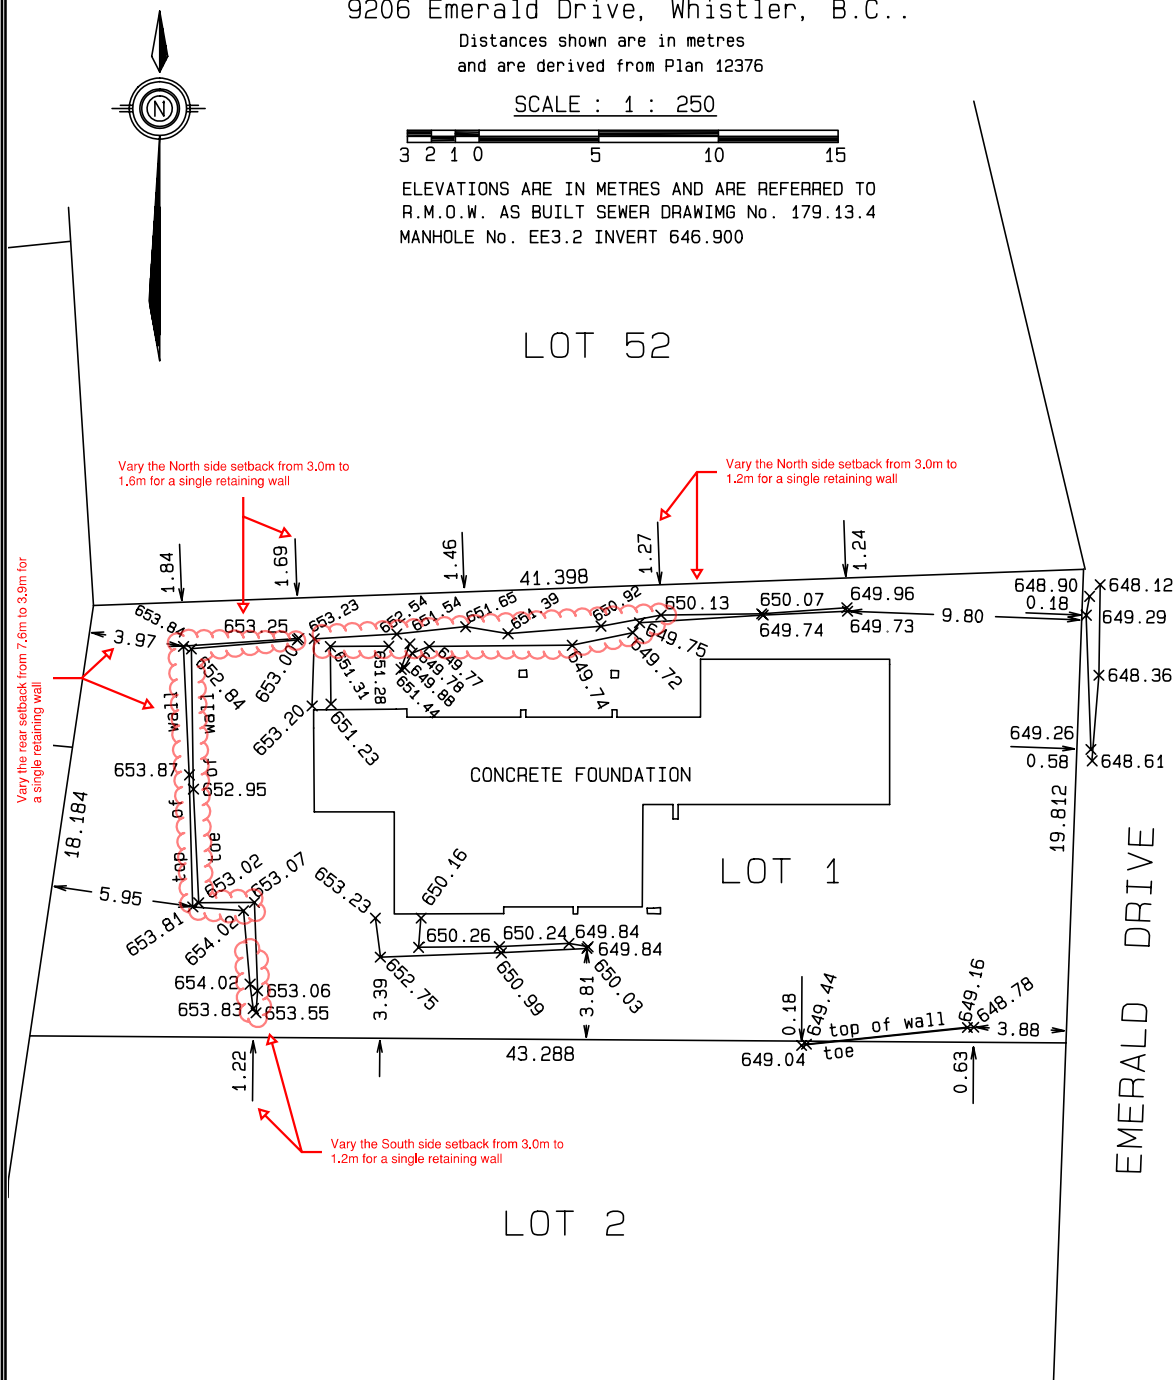

THIS DOCUMENT SHOWS THE RELATIVE LOCATION OF
 THE SURVEYED STRUCTURES AND FEATURES WITH
 RESPECT TO THE BOUNDARIES OF THE
 PARCEL DESCRIBED ABOVE. THIS DOCUMENT IS NOT
 A BOUNDARY SURVEY AND SHALL NOT BE USED TO
 DEFINE PROPERTY LINES OR PROPERTY CORNERS

Paul Bunbury

Digitally signed by Paul Bunbury
 DN: cn=Paul Bunbury, o=ou,
 email=paul@bunbury-surveys.com, c=CA
 Date: 2020.05.20 13:26:50 -07'00'

B.C.L.S.

May 15, 2020

© BUNBURY AND ASSOCIATES 2019

All rights reserved. No persons may copy, reproduce
 transmit or alter this document in whole or
 in part without the consent of the signatory

THIS DRAWING IS NOT VALID UNLESS DIGITALLY
 OR ORIGINALLY SIGNED AND SEALED.

THIS DOCUMENT WAS PREPARED FOR MORTGAGE AND
 OR MUNICIPAL/REGIONAL DISTRICT PURPOSES
 AND IS FOR THE EXCLUSIVE USE OF OUR CLIENT.

THE SIGNATORY ACCEPTS NO RESPONSIBILITY
 OR LIABILITY FOR ANY DAMAGES THAT MAY BE
 SUFFERED BY A THIRD PARTY AS A RESULT
 OF ANY DECISIONS MADE OR ACTIONS TAKEN
 BASED ON THIS DOCUMENT

BUNBURY & ASSOCIATES

PROFESSIONAL B.C. LAND SURVEYORS,

SQUAMISH & WHISTLER, BC www.bunbury-surveys.com

No. 204-1085 MILLAR CREEK ROAD, WHISTLER, B.C., 604-932-3770

JOB FILE 2017-027 DATA FILE 17-02716.dat

L-0072